



ALLEY

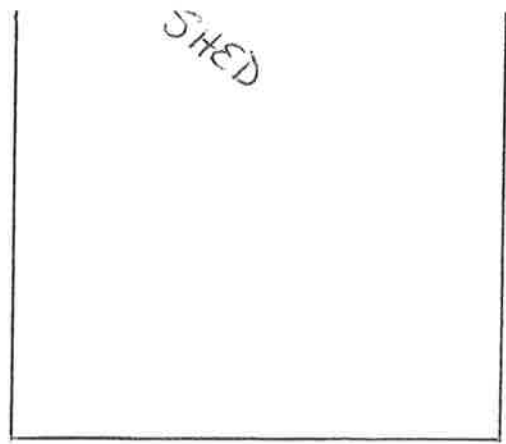

As-Built

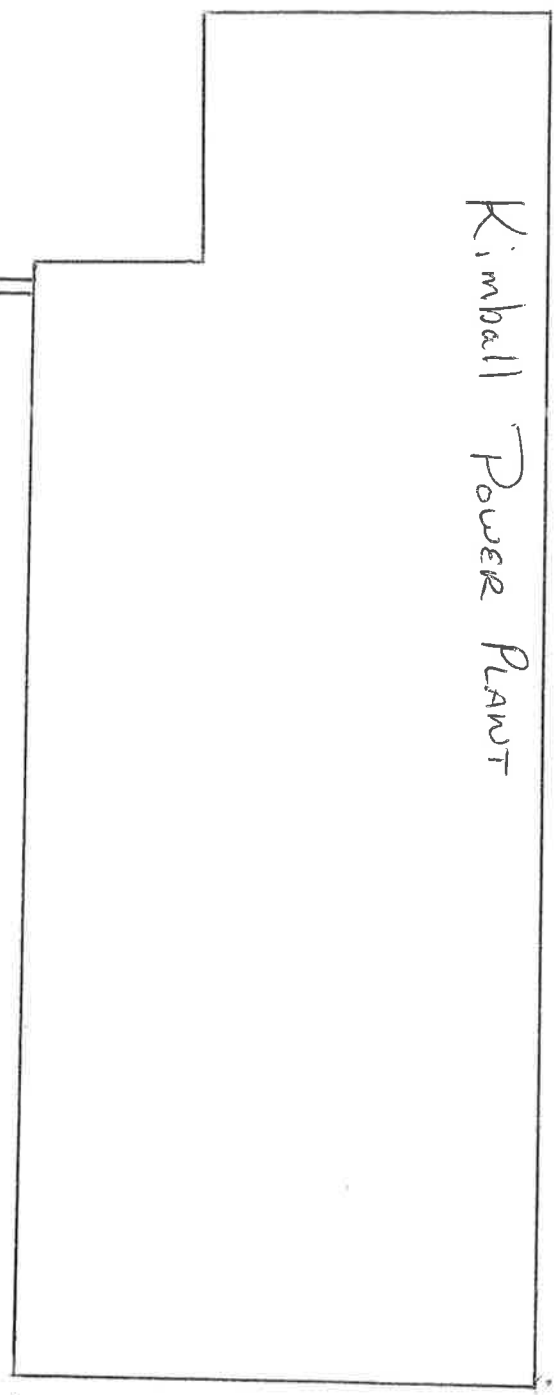


Gravel Lot

EXISTING
 TO STEEL LINES
 TO 90° TURN


56'

RETURN


Product

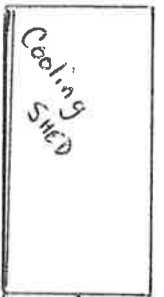

8'

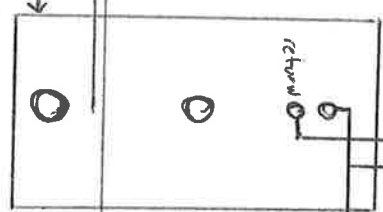

10'

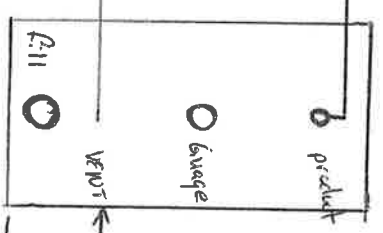

2'

10'

9'

17'

27'

10'

S. HOWARD St.

01/00/14

3" FIBERGLASS SUPPLY LINE

3" FIBERGLASS RETURN LINE

3" SUPPLY LINE 3 1/2' DEEP

3" RETURN LINE 3 1/2' DEEP

3" STEEL LINE BETWEEN TANKS 3 1/2' DEEP

TOP OF FUEL TANKS 4' DEEP

② 3" X 12" REPAIR DRASSIER SCREENS 12' TO 15' NORTH OF WEST FUEL TANK.

3" FIBERGLASS LINES RUN UNDER STEEL CONDUIT NORTH OF WEST FUEL TANK.

② STEEL CONDUIT LINES RUN NORTH TO BUILDING AND NORTH OF WEST FUEL TANK. (NOTE: FOUND ANOTHER STEEL CONDUIT LINE JUST ABOVE 3" LINES)

STEEL CONDUIT LINES 6" TO 8" DEEP.